


LABOR AND MATERIALS

1	Copper Lead	Connection	3/4"	\$	2.71
1	Curb	Cock Valve T.S. & V.	3/4 in.	\$	3.83
1	Service box	Short 3 1/2 x 4 1/2		\$	4.69
	Old returned	Long 4 1/2 x 5 1/2		\$	
		Buff or Rdway		\$	
12	Ft. 3/4 in.	Copper Pipe at	45	\$	5.40
		G.I.		\$	
		C.I.		\$	
	Nipples	in. at		\$	
	Bushings	to in. at		\$	
	Red'g Inc'g	Coupl'gs to in. at		\$	
	Union	in. at		\$	
	Meter	in. at		\$	
	Lead Joints at			\$	
	Compound Joints at			\$	
	Maintenance Foreman			\$	
	Hrs. Water Maint. Man-1 at			\$	
7	Hrs. Water Maint. Man-2 at	1.24		\$	8.68
	Hrs. Garage Foreman at			\$	
14	Hrs. Labor at	1.13		\$	15.82
	Hrs. Compressor at			\$	
	Compensation Ins. at \$	4.29	per C	\$	1.05
	Trucking			\$	6.50
	Pay't Patch			\$	18.00
	Tap by Gifford			\$	
		4-13-55		\$	
	O'head			\$	
				\$	61.68

MONUMENT -St.  
-Pl.  
Ave. No. 23

Name of Owner  
George Hoffis

Labor and Mat'l. Report April 13 19 55

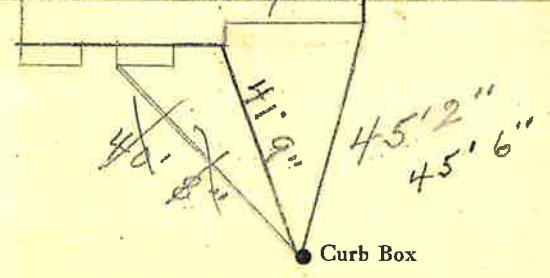

6" Main Elev. of Main at tap 4"

Gate at • • Gate at

• Curb Box

Tax ID# 302.11-7-23