

Labor and Materials


.....	Copper	} Connection.....	3 4	\$ 1.33			
.....	Lead							
.....	Curb	} Cock Valve Tr.Serv.	}	in	\$ 1.58			
.....	Service Box							
.....	Old returned	} Short 3 1/2 x 4 1/4 Long 4 1/2 x 5 1/2 Diff. or Redway	}	\$ 1.36			
31	Ft. 2 4					Copper	} Pipe at
.....	Nipples	Cast Iron						
.....	Bushings	to	in.	at	\$
.....	Red'g Inc'g	} Couplings.....	} to	in.	at	\$
.....	Union.....							
.....	Meter.....	in.	at	\$			
.....	Lbs. Br. Stone	at	\$				
.....	Lbs. Sand	at	\$				
.....	Bags Cement	at	\$				
.....	Paving Brick	} Mack Red Asphalt	} at	\$			
.....	Lead Joints					at	\$
.....	Leadite Joints					at	\$
3	Hrs. Foreman	at	\$	1.88			
5	Hrs. Common Labor	at	Tapper	\$	2.50		
8	Hrs. Common Labor	at	\$	3.60			
.....	Hrs. Mason	at	\$				
.....	Hrs. Masons Helper	at	\$				
.....	Hrs. Compressor	at	\$				
.....	Compensation Ins	\$	1.25			
.....	Trucking	\$	1.00			
.....	Builder's Use of Water	Patch	\$	5.00			
Total \$					21.55			

33-116

Labor and Material Report

May 1 1933

24 Monument Ave

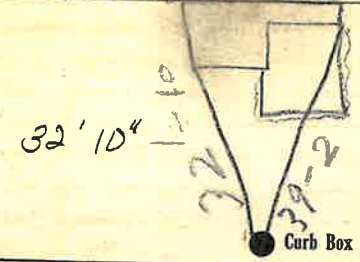

6 Main

Elev. of Main at tap 4 1/2

Gate at ●

● Gate at

● Curb Box

old Taps shut off
TAX ID# 302.11-8-8

[Handwritten signature]

m