
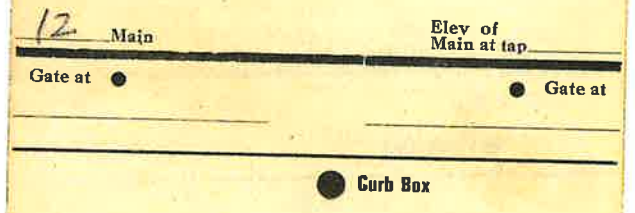


Labor and Materials

1	Copper	Connection	?	\$ 2.60
1	Curb	Cock Valve T. S. & V.	in.	\$ 2.30
1	Service Box	Short $3\frac{1}{2} \times 4\frac{1}{2}$		\$ 1.40
	Old returned	Long $4\frac{1}{2} \times 5\frac{1}{2}$ Buff or Redway		
2	Ft.	Copper Galv. Iron Pipe at	in.	\$ 5.57
	Nipples	in. at		\$
	Bushings	to in. at		\$
	Red'g Inc'g	Couplings to in. at		\$
	Union	in. at		\$
	Meter	in. at		\$
	Lbs. Br. Stone	at		\$
	Lbs. Sand	at		\$
	Bags Cement	at		\$
	Paving Brick	Mack Red Asphalt at		\$
	Lead Joints	at		\$
	Leadite Joints	at		\$
4	Hrs. Foreman	at		\$ 7.50
25	Hrs. Common Labor	at		\$ 10.16
	Hrs. Common Labor	at		\$
	Hrs. Mason	at		\$
	Hrs. Mason's Helper	at		\$
	Hrs. Compressor	at		\$
	Compensation Ins.			\$ 3.4
	Trucking			\$ 1.00
	Builders' Use of Water	Patch		\$ 5.-
Total \$				30.57

Morgan Ave

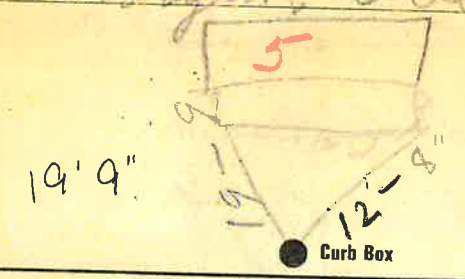

Old Tap disconnected
Tax ID# 303.17-1-19