

## LABOR AND MATERIALS

Copper	Lead	Connection	3/4			\$ 2.94
Curb	Cock Valve	P. S. & V.	3/4	in.		\$ 3.71
Service box	Old returned	Short 3/4 X 4 1/2				
		Long 4 1/2 X 5 1/2				
		Buffer Rdway				\$ 5.90
7 Ft.	3/4 in.	Copper				
		G. I.			30	\$ 3.00
		C. I.				
Nipples	in. at					\$
Bushings	to in. at					\$
Red'g						
Inc'g	Coupl'gs to in. at					\$
Union	in. at					\$
Meter	in. at					\$
Lead Joints	at					\$
Compound Joints	at					\$
1	Hrs. Water Maint. Man-1		112			\$ 1.12
11	Hrs. Water Maint. Man-2		1.02			\$ 11.22
14	Hrs. Labor		91			\$ 12.74
	Hrs. Labor					\$
	Hrs. Compressor	at				\$
	Compensation Ins. at \$	per C.				\$ 53
	Trucking					\$ 1.00
	Pav't Patch					\$ 7.10
	Tap by Morgan					\$
	O'head					\$
						\$ 48.26

127.

St.

Pl.


Ave. No. 14

Name of Owner

Sackman

Labor and Mat'l. Report

Sept 29 1948

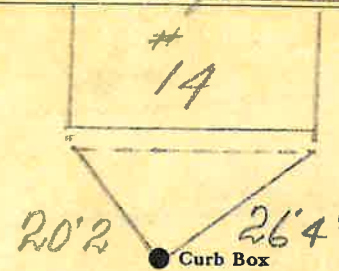

12 Main

Elev. of Main at tap 5

Gate at ●

● Gate at

● Curb Box

Tax 10<sup>th</sup> 303.13-23-21