

LABOR AND MATERIALS

1	Copper	} Connection $\frac{3}{4}$ "	\$ 2.71
	Lead		
1	Curb	} $\frac{3}{4}$ in.	\$ 3.83
	Cock Valve T.S. & V.		
1	Service box	} { Short $3\frac{1}{2}$ x $4\frac{1}{2}$ Long $4\frac{1}{2}$ x $5\frac{1}{2}$ Buff. or Rdway. }	\$ 4.69
	Old returned		
9	Ft. $\frac{3}{4}$ in.	} { Copper G.I. G.I. }	Pipe at 45 \$ 4.05
	Nipples	in. at	\$
	Bushings	to in. at	\$
	Red'g	} Coupl'gs. to in. at	\$
	Ine'g		
	Union	in. at	\$
	Meter	in. at	\$
	Lead Joints	at	\$
	Compound Joints	at	\$
	Maintenance Foreman		\$
	Hrs. Water Maint. Man-1	at	\$
2	Hrs. Water Maint. Man-2	at 1.24	\$ 2.48
	Hrs. Garage Foreman	at	\$
11	Hrs. Labor	at 1.13	\$ 12.43
	Hrs. Compressor	at	\$
	Compensation Ins. at \$ 5.86	per C	\$ 85
	Trucking		\$ 1.50
	Pav't Patch		\$ 7.20
	Tap by Gifford		\$
	2-29-56.		\$
	O'head		\$
			\$ 39.74


Morgan

St. Pl. Ave. No. 16

Name of Owner

Elizabeth Jarley

Labor and Mat'l. Report Feb. 29 1956

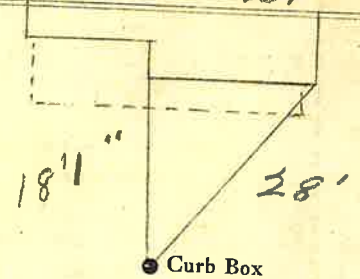

12" Main

Elev. of Main at tap $4\frac{1}{2}$ '

Gate at •

• Gate at

• Curb Box

Tax 10# 303.13-23-22