


30-6 17  
 Labor and Material Report *Mar 12 1930*

11 *main*

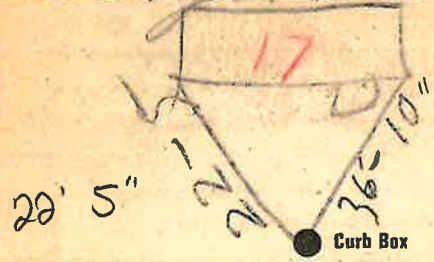

12 Main Elev of Main at tap *4*  
 Gate at ● ● Gate at

● Curb Box

*old Tap driver  
 & chief*  
 Tax ID # 303.17-1-12

**Labor and Materials**

Copper } Connection	<i>3</i>	\$ 2.60
Curb { Cock Valve } T.S. & V.	<i>1/3</i>	\$ 2.30
Service Box } Old returned	<i>1/4</i>	\$ 1.40
26 Ft. } in. } Copper Galv. Iron } Pipe at	<i>3/4</i>	\$ 6.89
Nipples	in. at	\$
Bushings	to in. at	\$
Red'g } Inc'g } Couplings	to in. at	\$
Union	in. at	\$
Meter	in. at	\$
Lbs. Br. Stone	at	\$
Lbs. Sand	at	\$
Bags Cement	at	\$
Paving Brick } Mack } Red } Asphalt }	at	\$
Lead Joints	at	\$
Leadite Joints	at	\$
<i>18</i> Hrs. Foreman		\$ <i>11.25</i>
<i>7</i> Hrs. Common Labor at <i>Tapper @ .50</i>		\$ <i>3.50</i>
<i>75</i> Hrs. Common Labor		\$ <i>10.16</i>
Hrs. Mason	at	\$
Hrs. Mason's Helper	at	\$
<i>4</i> Hrs. Compressor	at	\$ <i>6.00</i>
Compensation Ins.		\$ <i>.76</i>
Trucking		\$ <i>1.00</i>
Builders' Use of Water	<i>Patch</i>	\$ <i>5.00</i>
Total		\$ <i>50.86</i>