

Labor and Materials


| | | | |
|-----------|--|-------|-------|
| 1 | Copper } Connection..... | 2 | 96 |
| 1 | Lead } | | |
| 1 | Curb { Cock Valve } | 4 | 1.33 |
| 1 | Service Box { Short 3-2 x 1-1/2 } | 4 | 1.35 |
| | Old returned { Long 4 1/2 x 6 1/2 } | | |
| 9 | Ft. 3/4 in. { Copper Galv. Iron } Pipe at 15 | | 1.20 |
| | Cast Iron } | | |
| | Nipples | | |
| | Bushings | | |
| | Red'g } Couplings..... | | |
| | Inc'g } | | |
| | Union..... | | |
| | Meter..... | | |
| | Lbs. Br. Stone at | | |
| | Lbs. Sand at | | |
| | Bags Cement at | | |
| | Paving Brick { Mack Red Asphalt } at | | |
| | Lead Joints at | | |
| | Leadite Joints at | | |
| 5 | Hrs. Foreman at | 6 1/2 | 3.13 |
| 4 | Hrs. Common Labor at | 50 | 2.00 |
| 8 | Hrs. Common Labor at | 45 | 3.60 |
| | Hrs. Mason at | | |
| | Hrs. Masons Helper at | | |
| | Hrs. Compressor at | | |
| | Compensation Ins | | 2.7 |
| | Trucking | | 1.00 |
| | Builders Use of Water Patch | | 5.00 |
| Total \$. | | | 19.84 |

Labor and Material Report

12

18

24' House.

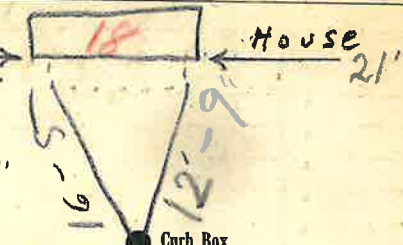

June 25 1930

12

Main

Elev of Main at tap 9 1/2

Gate at ●

● Gate at

● Curb Box

old shut off

Tax ID # 303.13-23-24