

Labor and Materials


Copper } Connection.....	96
Lead }	
Curb { Cock Valve }	1.33
{ U.S. & V. }	
Service Box { Short 3 1/2 x 4 1/2 }	1.35
Old returned { Long 4 1/2 x 5 1/2 }	
{ Buff. or Ridway }	
12 Ft. 3/4 in. { Copper } Pipe at 15	1.80
{ Galv. Iron }	
{ Cast Iron }	
Nipples	
Bushings	
Red'g } Couplings.....	
Inc'g }	
Union.....	
Meter.....	
Lbs. Br. Stone at	
Lbs. Sand at	
Bags Cement at	
Paving Brick { Mack } at	
{ Red }	
{ Asphalt }	
Lead Joints at	
Leadite Joints at	
3 Hrs. Foreman at ..	1.88
1.4 Hrs. Common Labor at ..	6.30
Hrs. Common Labor at	
Hrs. Mason at	
Hrs. Masons Helper at	
Hrs. Compressor at	
Compensation Ins	25
Trucking'	1.00
Builders Use of Water Patch	5.00

Total \$ 19.87

Labor and Material Report

6 1936

19 Measurement

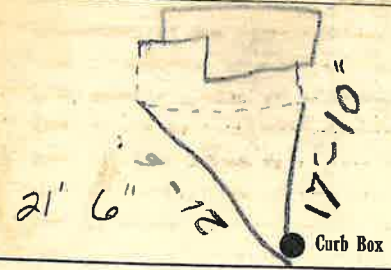

6 Main Elev. of Main at tap 4.2

Gate at ● Gate at ●

● Curb Box

old shut off gate main

Handwritten initials or mark.