

Labor and Materials


Copper	Connection	3	\$ 2.70
Lead		1	
Curb	Cock Valve T.S. & V.	3/4	\$ 2.39
Service Box	Short 1 1/2 x 1 1/2		\$ 1.55
Old returned	Long 4 1/2 x 5 1/2		
	Butt or Railway		
8 Ft.	Copper Galv. Iron Pipe at	3/4	\$ 2.16
	Cast Iron		
Nipples	in. at		\$
Bushings	to in. at	3/4	\$ 1.0
Red'g Inc'g	Couplings to in. at		\$
Union	in. at		\$
Meter	in. at		\$
Lbs. Br. Stone	at		\$
Lbs. Sand	at		\$
Bags Cement	at		\$
Paving Brick	Mack Red Asphalt at		\$
Lead Joints	at		\$
Leadite Joints	at		\$
4 Hrs.	Foreman at		\$ 2.50
18 Hrs.	Common Labor at		\$ 8.10
Hrs.	Common Labor at		\$
Hrs.	Mason at		\$
Hrs.	Mason's Helper at		\$
Hrs.	Compressor at		\$
Compensation Ins			\$ 3.3
Trucking			\$ 1.-
Builders' Use of Water	Patch		\$ 5.-
Total \$			25.83

30-101 20

Labor and Material Report

Aug. 19 19 20

19 *Wagon*

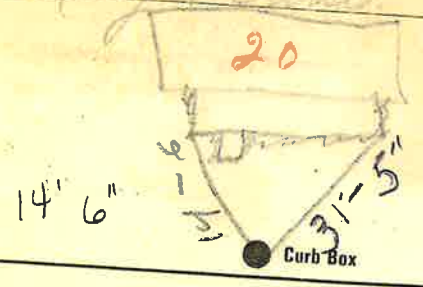

12 Main

Elev of Main at tap 4

Gate at ●

● Gate at

● Curb Box

Old tap instrument

Tax 10# 303.13 - 23.25