

Labor and Materials


Copper	Connection	3	\$ 2.60
Curb	Cock Valve	1	\$ 2.27
Service Box	Short 3/4 x 1 1/2		\$ 1.59
Old returned	Long 4 1/2 x 5 1/2		
	Butt for Redway		
9	3/4 in. Copper		\$ 1.67
	Cast Iron		
	Pipe at		
	Nipples		
	Bushings		
	Red'g Inc'g		
	Couplings		
	Union		
	Meter		
	Lbs. Br. Stone at		
	Lbs. Sand at		
	Bags Cement at		
	Paving Brick		
	Mack Red Asphalt		
	Lead Joints at		
	Leadite Joints at		
4	Hrs. Foreman at		\$ 7.50
18	Hrs. Common Labor at		\$ 8.10
	Hrs. Common Labor at		
	Hrs. Mason at		
	Hrs. Mason's Helper at		
	Hrs. Compressor at		
	Compensation Ins		\$.33
	Trucking		\$ 1.-
	Builders' Use of Water	Patch	\$ 5.-
Total			\$ 25.01

31-140 22

Labor and Material Report

Sept. 10 1931

16 Margaret Ave.

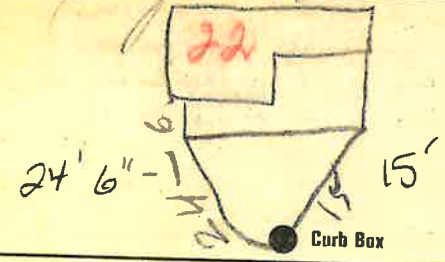

12 Main

Elev of Main at tap 61

Gate at ●

● Gate at

● Curb Box

Old tap dis -
connected.

NOTE - WHEN CURB STOP IS IN
"OFF" POSITION IT IS "ON"

TAX 10# 303.13-23-26