


Labor and Materials

1	Copper } Connection $\frac{3}{4}$ "	\$ 3.20
	Lead	
1	Curb { Cock Valve T-S-&V. } $\frac{3}{4}$ " in.	\$ 1.00
1	Service Box { Short $3\frac{1}{2}$ x $4\frac{1}{2}$ } Old returned { Long $4\frac{1}{2}$ x $5\frac{1}{2}$ } Buff. or Rdway }	\$ 1.30
24	Ft. $\frac{3}{4}$ " in. { Copper Galv. Iron } Pipe at.	\$ 5.28
	Cast Iron	
	Nipples..... in. at.....	\$
	Bushings..... to..... in. at.....	\$
1	Red'g } Couplings..... to <i>Paralle</i> in. at.....	\$ 1.5
	Inc'g	
	Union..... in. at.....	\$
	Meter..... in. at.....	\$
	Lbs Br. Stone at.....	\$
	Lbs. Sand at.....	\$
	Bags Cement at.....	\$
	Paving Brick { Mack Red Asphalt } at.....	\$
	Lead Joints at.....	\$
	Leadite Joints at.....	\$
6	Hrs. Foreman at <i>62.5</i>	\$ 3.75
20	Hrs. Common Labor at <i>50</i>	\$ 1.00
	Hrs. Common Labor at.....	\$
	Hrs. Mason at.....	\$
	Hrs. Mason's Helper at.....	\$
	Hrs. Compressor at.....	\$
	Compensation Ins.....	\$ 1.39
	Trucking.....	\$ 1.00
	Builders' Use of Water.....	\$
Total		\$ <u>27.07</u>

23
Labor and Material Report June 18 1926

3/4" tap at 15 Morgan Ave

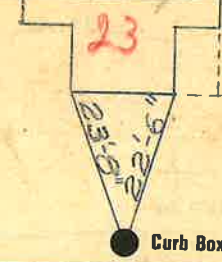

15" Main Elev. of Main at tap *34*
 Gate at ● ● Gate at

● Curb Box

TAX ID # 303.17-1-10