


LABOR AND MATERIALS

1 Copper } Connection ^{3/4"} \$ _____
 Lead }
 1 Curb } Cock } 3/4 in. \$ _____
 } Valve }
 } T. S. & V. }
 1 Service box } Short 3 1/2 x 4 1/2 }
 Old returned } Long 4 1/2 x 5 1/2 } \$ _____
 } Buff or Rdway }
 8 Ft. ^{3/4} in. } Copper } Pipe at \$ _____
 } C. I. }
 } C. I. }
 Nipples in. at \$ _____
 Bushings to in. at \$ _____
 Red'g }
 Inc'g } Coupl'gs to in. at \$ _____
 Union in. at \$ _____
 Meter in. at \$ _____
 Lead Joints at \$ _____
 Compound Joints at \$ _____
 Maintenance Foreman \$ _____
 Hrs. Water Maint. Man-1 at \$ _____
 Hrs. Water Maint. Man-2 at \$ _____
 Hrs. Garage Foreman at \$ _____
 Hrs. Labor at \$ _____
 Hrs. Compressor at \$ _____
 Compensation Ins. at \$ _____ per C \$ _____
 Trucking \$ _____
 Pav't Patch \$ _____
 Tap by Gisnard & Co. 9-13-60. \$ _____
 O'head \$ _____
 \$ _____

St. _____
 Pl. _____
 Ave. No. 6

Name of Owner Fiore

Labor and Mat'l. Report Sept. 13 1960

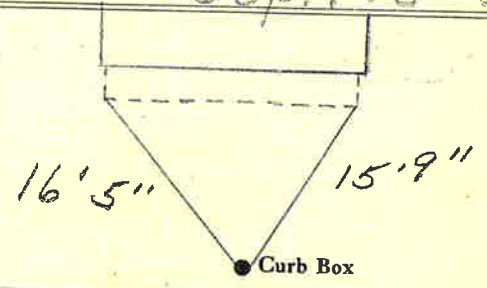

^{12"} Main Elev. of Main at tap 4'
 Gate at • Gate at

• Curb Box
 Tax ID# 303.13-23-17