

LABOR AND MATERIALS

1	Copper	} Connection	3/4"	\$	
	Lead				
1	Curb	} Cock Valve T.S. & V.	3/4" in.	\$	
1	Service box				
	Old returned				
			Short 3 1/2 x 4 1/2	\$	
			Long 4 1/2 x 5 1/2		
			Buff or Rdway		
7	3/4 in.	} Copper G.I. G.I.	} Pipe at	\$	
	Nipples	in.	at	\$	
	Bushings	to	in. at	\$	
	Red'g } Inc'g	} Coupl'gs	to	in. at	\$
	Union	in.	at	\$	
	Meter	in.	at	\$	
	Lead Joints	at			\$
	Compound Joints	at			\$
	Maintenance Foreman				\$
	Hrs. Water Maint. Man - 1	at			\$
	Hrs. Water Maint. Man - 2	at			\$
	Hrs. Garage Foreman	at			\$
	Hrs. Labor	at			\$
	Hrs. Compressor	at			\$
	Compensation Ins. at \$	per C		\$	
	Trucking				\$
	Pav't Patch				\$
	Tap by Gifford & Co. 8-21-58				\$
	O'head				\$


Tap by Gifford & Co. 8-21-58

O'head

Street Morgan
Pl. 28
Ave. No. 28

Name of Owner Frances Buckley

Labor and Mat'l. Report Aug. 21 1958

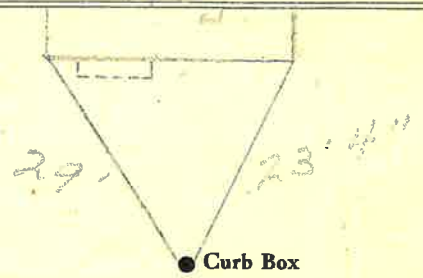

● Curb Box

12" Main Elev. of Main at tap 5'
Gate at ● Gate at ●

● Curb Box

Tax ID # 303.13-23-29