


Labor and Materials

|   |             |          |
|---|-------------|----------|
| Copper } Connection.....                  | 3           | \$ 1.50  |
| Lead } Connection.....                    | 3           | \$ 1.50  |
| Curb { Cock } .....                       | 1           | \$ 1.70  |
| { Valve } .....                           | 1           | \$ 1.70  |
| { T.S.&V. } .....                         | 1           | \$ 1.70  |
| Service Box { Short 3 1/2 x 4 1/2 } ..... | 1           | \$ 1.54  |
| Old returned { Long 4 1/2 x 5 1/2 } ..... | 1           | \$ 1.54  |
| { Buff. or Rdway } .....                  | 1           | \$ 1.54  |
| 27 Ft. .... in { Copper } Pipe at .....   | 3           | \$ 51.3  |
| { Galv. Iron } .....                      | 3           | \$ 51.3  |
| { Cast Iron } .....                       | 3           | \$ 51.3  |
| Nipples .....                             | in. at      | \$       |
| Bushings .....                            | to .....    | \$       |
| Red'g } Couplings .....                   | to .....    | \$       |
| Inc'g } Couplings .....                   | to .....    | \$       |
| Union .....                               | in. at      | \$       |
| Meter .....                               | in. at      | \$       |
| Lbs. Br. Stone at .....                   |             | \$       |
| Lbs. Sand at .....                        |             | \$       |
| Bags Cement at .....                      |             | \$       |
| Paving Brick { Mack } at .....            |             | \$       |
| { Red } .....                             |             | \$       |
| { Asphalt } .....                         |             | \$       |
| Lead Joints at .....                      |             | \$       |
| Leadite Joints at .....                   |             | \$       |
| 13 Hrs. Foreman at .....                  | 6 1/2       | \$ 8.13  |
| 33 Hrs. Common Labor at .....             | AS          | \$ 149.5 |
| Hrs. Common Labor at .....                |             | \$       |
| Hrs. Mason at .....                       |             | \$       |
| Hrs. Masons Helper at .....               |             | \$       |
| Hrs. Compressor at .....                  |             | \$       |
| Compensation Ins. ....                    |             | \$ 28.2  |
| Trucking .....                            |             | \$ 3.-   |
| Builders Use of Water                     | Paul. Patch | \$ 5.-   |
| Total                                     |             | \$ 41.67 |

142 34 7  
Labor and Material Report

Oct 22 1934

1 1/2 Morgan Ave

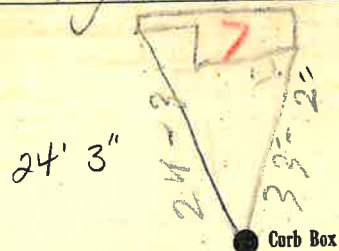

● Curb Box

12 Main

Elev. of Main at tap 4

Gate at ●

● Gate at

● Curb Box

old shut off at main

Tax ID # 303.17-1-18

A. Hearn

To be billed for  
pay.

M

MA