

Labor and Materials


4	Copper } Connection.....	3/4 in.	\$ 1.33
4	Lead } .....		
1	Curb { Cock Valve } .....	3/4 in.	\$ 1.58
1	Service Box { Short 3 1/2 x 4 1/2 } .....		\$ 1.36
	Old returned { Long 4 1/2 x 5 1/2 } .....		
25	Ft. 3/4 in. { Copper } Pipe at .....		\$ 2.37
	Nipples .....	in. at	\$ .....
	Bushings .....	to .....	in. at \$ .....
	Red'g } Couplings.....	to .....	in. at \$ .....
	Inc'g } .....		
	Union.....	in. at	\$ .....
	Meter.....	in. at	\$ .....
	Lbs. Br. Stone at .....		\$ .....
	Lbs. Sand at .....		\$ .....
	Bags Cement at .....		\$ .....
	Paving Brick { Mack Red Asphalt } at .....		\$ .....
	Lead Joints at .....		\$ .....
	Leadite Joints at .....		\$ .....
3	Hrs. Foreman at .....		\$ 1.88
8	Hrs. Common Labor at .....	Tapped	\$ 4.00
8	Hrs. Common Labor at .....		\$ 3.60
	Hrs. Mason at .....		\$ .....
	Hrs. Masons Helper at .....		\$ .....
	Hrs. Compressor at .....		\$ .....
	Compensation Ins .....		\$ 2.9
	Trucking .....		\$ 1.00
	Builders Use of Water Patch .....		\$ 5.00
Total			\$ 22.41

33-66 9

22 33  
19

Labor and Material Report

3

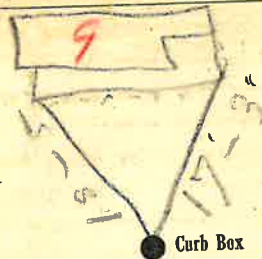

Curb Box

12

Main

Elev. of Main at tap 3-2

Gate at ●

● Gate at

● Curb Box

Old tap shut off at main

Tax ID # 303.17-1-17

*[Handwritten signature]*