

**Labor and Materials**


Copper } Connection.....	2	\$ 2.70
Lead } .....		
Curb } Cock Valve } .....	4	\$ 2.34
T.S. & V. } .....		
Service Box } Short 3 1/2 x 4 1/2 } .....	4	\$ 1.45
Old returned } Long 4 1/2 x 5 1/2 } .....		
Buff. or Rdway } .....		
Ft. .... in. } Copper Galv. Iron } Pipe at.....	3	\$ 1.62
Cast Iron } .....		
Nipples..... in. at.....		\$
Bushings..... to..... in. at.....		\$
Red'g } Couplings..... to..... in. at.....		\$
Inc'g } .....		
Union..... in. at.....		\$
Meter..... in. at.....		\$
Lbs. Br. Stone at.....		\$
Lbs. Sand at.....		\$
Bags Cement at.....		\$
Paving Brick } Mack Red Asphalt } at.....		\$
Lead Joints at.....		\$
Leadite Joints at.....		\$
3 Hrs. Foreman at.....		\$ 1.88
8 Hrs. Common Labor at.....		\$ 3.60
Hrs. Common Labor at.....		\$
Hrs. Mason at.....		\$
Hrs. Mason's Helper at.....		\$
Hrs. Compressor at.....		\$
Compensation Ins.....		\$ .18
Trucking.....		\$ 1. -
Builders' Use of Water Patch.....		\$ 5. -
Total \$		19.82

30-46 10

Labor and Material Report

May 19 1930

4 Morgan Ave.

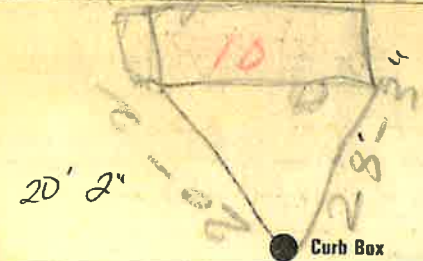

12

Main

Elev of Main at tap 4

Gate at ●

● Gate at

● Curb Box

old tap disconnected

Tax ID# 303.13-23-19