


Labor and Materials

1	Lead Connection	3/4	\$
1	Curb Cock		\$
1	Service Box	( <del>Standard</del> Long 4 1/2 x 5 1/2 Buffalo)	\$
23	Ft. .... in. G. I. Pipe at	/	\$
	Nipples	.... in. at	\$
1	Bushings	1 to 1/2 in. at	\$
	Red'g Coup	.... to .... in. at	\$
	Inc'g Coup	.... to .... in. at	\$
	Union	.... in. at	\$
	Meter	.... in. at	\$
	Cu. Yds. Br. Stone at		\$
	Cu. Yds. Sand at		\$
	Bags Cement at		\$
	Paving Brick	{ Mack Red Asphalt } at	\$
4	Hrs. Foreman at		\$
11	Hrs. Common Labor at		\$
	Hrs. Mason at		\$
3	Hrs.	at	\$
	Hrs.	at	\$
21	Builders' Use of Water		\$
	Truck	100	\$
		at	\$
		at	\$
		at	\$
		at	\$
	Total	\$ 13.41	

11 July 29 1929  
Labor and Material Report

5 Morgan Ave

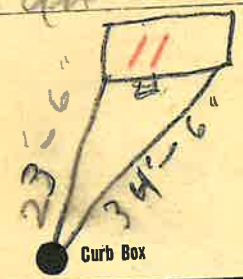

12 Main Elev. of Main at tap 4  
Gate at ● Gate at ●

● Curb Box

Tax 10¢ 303.17-1-16