


### LABOR AND MATERIALS

1	Copper <del>Lead</del>	Connection	<u>3/4"</u>	\$	
1	Curb	Cock Valve T-S. & V.	} <u>3/4</u> in.	\$	
1	Service box Old returned	{ Short $3\frac{1}{2} \times 4\frac{1}{2}$ Long $4\frac{1}{2} \times 5\frac{1}{2}$ Buff or Rdway	}	\$	
25	Ft.	<u>3/4</u> in.	{ Copper G.I. C.I.	} Pipe at	\$
	Nipples	in. at		\$	
	Bushings	to in. at		\$	
	Red'g Inc'g	Coupl'gs	to in. at	\$	
	Union	in. at		\$	
	Meter	in. at		\$	
	Lead Joints	at		\$	
	Compound Joints	at		\$	
	Maintenance Foreman			\$	
	Hrs. Water Maint. Man-1	at		\$	
	Hrs. Water Maint. Man-2	at		\$	
	Hrs. Garage Foreman	at		\$	
	Hrs. Labor	at		\$	
	Hrs. Compressor	at		\$	
	Compensation Ins.	at \$	per C	\$	
	Trucking			\$	
	Pav't Patch			\$	
				\$	
				\$	
	O'head			\$	
				\$	

St. \_\_\_\_\_  
Pl. \_\_\_\_\_  
Ave. No. 13

Name of Owner  
Esther Shaw

Labor and Mat'l. Report Aug 9 1966

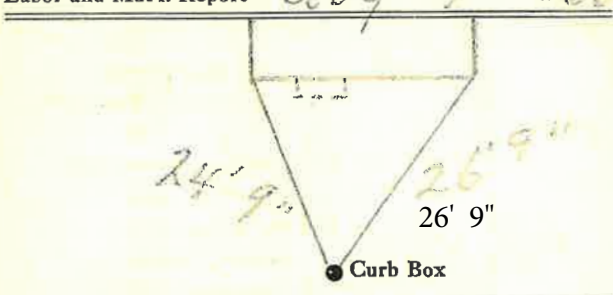

12" Main

Elev. of Main at tap 4 1/2'

Gate at • • Gate at

• Curb Box

TAX ID# 303.17-1-15