

### LABOR AND MATERIALS

1	Copper Lead	Connection	3/4	\$	1.35
1	Curb	Cock Valve T. S. & V.	3/4 in.	\$	1.80
1	Service Box Old returned	Short 3 1/2 x 4 1/2 Long 4 1/2 x 5 1/2 Buffer Rdway		\$	1.82
10	Ft.	3/4 in. Copper Galv Iron Cast Iron	Pipe at 191	\$	1.91
	Nipples	in. at		\$	
	Bushings	to in. at		\$	
	Red'g Inc'g	Couplings to in. at		\$	
	Union	in. at		\$	
	Meter	in. at		\$	
	Lead Joints at			\$	
	Leadite Joints at			\$	
	Hrs. Foreman at			\$	
8	Hrs. Chauffeur at	6.9 3/4		\$	5.50 1/2
7	Hrs. Tapper at			\$	4.81 1/2
7	Hrs. Labor at	5.5		\$	3.85 1/2
	Hrs. Labor at			\$	
1	Hrs. Compressor at	8.7 1/2		\$	.88
	Compensation Ins.	2.2 1/3		\$	.31
	Trucking			\$	1.00
	Builders Use of Water			\$	5.85
	Tap			\$	
				\$	
				\$	
				\$	
				\$	
				\$	29.09


3-43

St. Pl. Ave. No. 14

Morton

Name of Owner  
Garsten

Labor and Mat'l. Report  
Apr 7 19-43

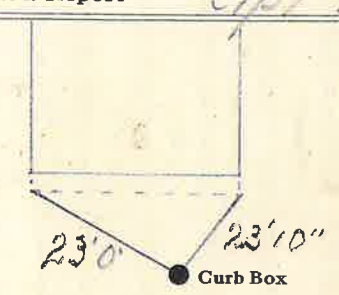

6 Main Elev. of Main at tap 6  
Gate at ● Gate at ●

● Curb Box

Tax ID # 309.7-8-21