

Labor and Materials


Copper } Connection.....	\$ 2.70
Lead }	
Curb } Cock Valve }	\$ 2.39
} P-S & V. }	
Service Box } Short 3 1/2 x 4 1/2 }	\$ 1.45
Old returned } Long 4 1/2 x 5 1/2 }	
} Buff. or Rdway }	
Ft. in. } Copper Galv. Iron } Pipe at... ..	\$ 3.24
} Cast Iron }	
Nipples..... in. at.....	\$
Bushings..... to..... in. at.....	\$
Red'g } Couplings..... to..... in. at.....	\$
Inc'g }	
Union..... in. at.....	\$
Meter..... in. at.....	\$
Lbs. Br. Stone at.....	\$
Lbs. Sand at.....	\$
Bags Cement at.....	\$
Paving Brick } Mack Red Asphalt } at.....	\$
Lead Joints at.....	\$
Leadite Joints at.....	\$
6 Hrs. Foreman at.....	\$ 3.75
20 Hrs. Common Labor at.....	\$ 9.-
Hrs. Common Labor at.....	\$
Hrs. Mason at.....	\$
Hrs. Mason's Helper at.....	\$
Hrs. Compressor at.....	\$
Compensation Ins.....	\$ 3.9
Trucking.....	\$ 1.-
Builders' Use of Water.....	\$ 5.-
Total \$ 28.92	

30-110

Labor and Material Report

Aug. 27, 1930

18 Weston St

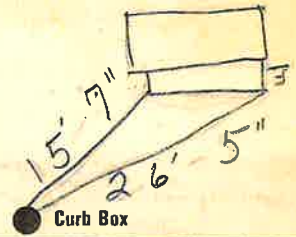

Main Elev of Main at tap

Gate at ● ● Gate at

● Curb Box

Old tap disconnected.

Tax ID# 309.7-8-23