


Labor and Materials

.....	Copper } Connection.....	3	\$ 96
.....	Lead }	4	\$ 1.33
.....	Curb { Cock Valve T.S.&V. }in	1	\$ 1.35
.....	Service Box { Short 3 1/2 x 4 1/2 Long 4 1/2 x 5 1/2 }		\$ 1.50
.....	Old returned { Buff. or Railway }		\$
10	Ft. 3/4 in. { Copper Galv. Iron Cast Iron } Pipe at	15	\$ 1.50
.....	Nipplesin. at		\$
.....	Bushingstoin. at		\$
.....	Red'g } Couplings.....to.....in.at		\$
.....	Inc'g }		\$
.....	Union.....in. at		\$
.....	Meter.....in. at		\$
.....	Lbs. Br. Stone at		\$
.....	Lbs. Sand at		\$
.....	Bags Cement at		\$
.....	Paving Brick { Mack Red Asphalt } at		\$
.....	Lead Joints at		\$
.....	Leadite Joints at		\$
7	Hrs. Foreman at <i>Chief 6 2/3</i>		\$ 4.38
17	Hrs. Common Labor at <i>4 5</i>		\$ 5.40
.....	Hrs. Common Labor at		\$
.....	Hrs. Mason at		\$
.....	Hrs. Masons Helper at		\$
.....	Hrs. Compressor at		\$
.....	Compensation Ins		\$ 30
.....	Trucking		\$ 1-
.....	Builders Use of Water <i>Patch</i>		\$ 5-
Total			\$ 21.27

88-36
Labor and Material Report

Sept 26 1931

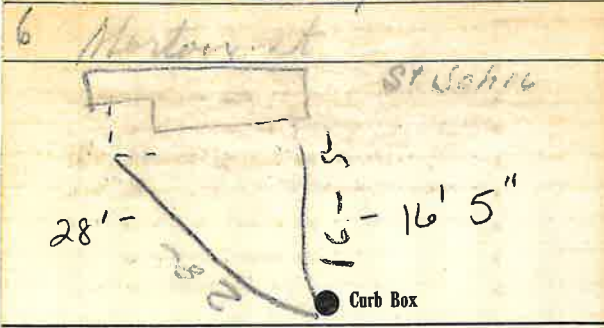

6 Main Elev. of Main at tap 5 1/2

Gate at ● Gate at ●

● Curb Box

Old top shut off

Tax ID # 309.7-8-17