


Labor and Materials

Copper } Connection.....	3	96
Lead }	4	\$
Curb { Cock }	2	1.33
{ Valve }	1	\$
{ T.S. & W. }	2	1.35
Service Box { Short 3 1/2 x 4 1/2 }		\$
Old returned { Long 4 1/2 x 5 1/2 }		\$
{ Buff. or Rdway }		\$
12 Ft. in. { Copper } Pipe at 15	5	1.80
{ Galv. Iron }		\$
{ Cast Iron }		\$
Nipples in. at		\$
Bushings to in. at		\$
Red'g } Couplings..... to..... in. at		\$
Inc'g }		\$
Union..... in. at		\$
Meter..... in. at		\$
Lbs. Br. Stone at		\$
Lbs. Sand at		\$
Bags Cement at		\$
Paving Brick { Mack } at		\$
{ Red }		\$
{ Asphalt }		\$
Lead Joints at		\$
Leadite Joints at		\$
4 Hrs. Foreman at	6 1/2	2.50
4 Hrs. Common Labor at	50	2.00
4 Hrs. Common Labor at	45	1.80
Hrs. Mason at		\$
Hrs. Masons Helper at		\$
Hrs. Compressor at		\$
Compensation Ins20
Trucking1-
Builders Use of Water Patch5-
Total \$		17.94

Labor and Material Report

4136
24, 1935

8 Martine St.

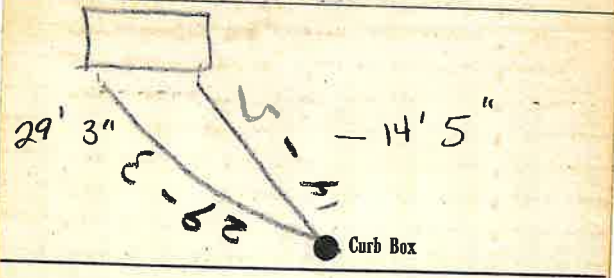

6 Main Elev. of Main at tap 5

Gate at ● ● Gate at

● Curb Box

old Tap shut off

TAX 10# 309.7-8-18

S.M.