

LABOR AND MATERIALS

1	Copper Lead	Connection	3/4"	\$
1	Curb	Cock Valve F.S. & V.	in.	\$
1	Service box Old returned	Short 3 1/2 x 4 1/2 Long 4 1/2 x 5 1/2 Buff or Rdway		\$
11	Ft. 3/4 in.	Copper S.I. C.I.	Pipe at	\$
	Nipples	in. at		\$
	Bushings	to in. at		\$
	Red'g } Inc'g }	Coupl'gs	to in. at	\$
	Union	in. at		\$
	Meter	in. at		\$
	Lead Joints	at		\$
	Compound Joints	at		\$
	Maintenance Foreman			\$
	Hrs. Water Maint. Man-1	at		\$
	Hrs. Water Maint. Man-2	at		\$
	Hrs. Garage Foreman	at		\$
	Hrs. Labor	at		\$
	Hrs. Compressor	at		\$
	Compensation Ins. at \$	per C		\$
	Trucking			\$
	Pav't Patch			\$
	Tap by Gifford & Co. 4-2-62.			\$
	O'head			\$

Morton


St. ~~Pl.~~
Ave. No. 10

Name of Owner

Julia O'Leary.

Labor and Mat'l. Report

Apr. 2 19 62.

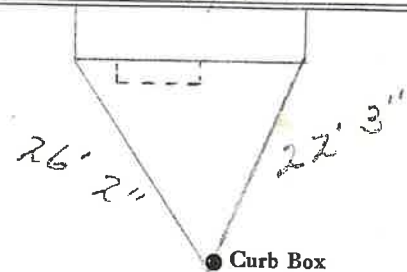

● Curb Box

6" C.I.
Main

Elev. of
Main at tap 5 1/2'

Gate at ●

● Gate at

● Curb Box

Tax ID# 309.7-8-19