

LABOR AND MATERIALS


1	Copper Lead	{ Connection	$\frac{3}{4}$ "		\$
1	Curb	{ Cock Valve T. S. & V. }	$\frac{3}{4}$ in.		\$
1	Service Box Old returned	{ Short $3\frac{1}{2} \times 4\frac{1}{2}$ Long $4\frac{1}{2} \times 5\frac{1}{2}$ Buff. or Rdway }			\$
10	$\frac{3}{4}$ in.	{ Copper Galv Iron Cast Iron }	Pipe at		\$
	Nipples	in. at			\$
	Bushings	to in. at			\$
	Red'g Inc'g	{ Couplings	to in. at		\$
	Union	in. at			\$
	Meter	in. at			\$
	Lead Joints	at			\$
	Leadite Joints	at			\$
	Hrs. Foreman	at			\$
	Hrs. Chauffeur	at			\$
	Hrs. Tapper	at			\$
	Hrs. Labor	at			\$
	Hrs. Labor	at			\$
	Hrs. Compressor	at			\$
	Compensation Ins.				\$
	Trucking				\$
	Builders Use of Water				\$
	Tap by G. S. S. & Co.				\$
	10-20-58				\$
					\$
					\$
					\$

St.
Pl.
Ave. No. 12

Morton

Name of Owner
Percy J. King

Labor and Mat'l. Report Oct. 20 1958

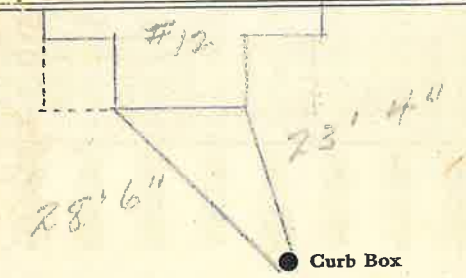

Elev. of
Main at tap. $5\frac{1}{2}$ '

6" Main
Gate at ● Gate at ●

● Curb Box

TAX ID# 309.7-8-20