


LABOR AND MATERIALS

1 Copper } Connection 1" \$ \_\_\_\_\_  
 Lead }  
 1 Curb } Cock } 1 in. \$ \_\_\_\_\_  
 Valve }  
 T.S. & V. }  
 1 Service box } Short 3 1/2 x 4 1/2 }  
 Old returned } Long 4 1/2 x 5 1/2 } \$ \_\_\_\_\_  
 } Buff or Rdway }  
 30 Ft. in. } Copper } Pipe at \$ \_\_\_\_\_  
 } C.I. }  
 } C.I. }  
 Nipples in. at \$ \_\_\_\_\_  
 Bushings to in. at \$ \_\_\_\_\_  
 Red'g }  
 Inc'g } Coupl'gs to in. at \$ \_\_\_\_\_  
 Union in. at \$ \_\_\_\_\_  
 Meter in. at \$ \_\_\_\_\_  
 Lead Joints at \$ \_\_\_\_\_  
 Compound Joints at \$ \_\_\_\_\_  
 Maintenance Foreman \$ \_\_\_\_\_  
 Hrs. Water Maint. Man-1 at \$ \_\_\_\_\_  
 Hrs. Water Maint. Man-2 at \$ \_\_\_\_\_  
 Hrs. Garage Foreman at \$ \_\_\_\_\_  
 Hrs. Labor at \$ \_\_\_\_\_  
 Hrs. Compressor at \$ \_\_\_\_\_  
 Compensation Ins. at \$ \_\_\_\_\_ per C \$ \_\_\_\_\_  
 Trucking \$ \_\_\_\_\_  
 Pav't Patch \$ \_\_\_\_\_  
 Tap by Gifford, Miller \$ \_\_\_\_\_  
 + Co. 3-31-64. \$ \_\_\_\_\_  
 O'head \$ \_\_\_\_\_  
 \$ \_\_\_\_\_

Shut off for 1" main on  
 Rd. \_\_\_\_\_  
 St. \_\_\_\_\_  
 Pl. \_\_\_\_\_  
 Mountain View Ave. No. \_\_\_\_\_

Name of Owner \_\_\_\_\_

Labor and Mat'l. Report March 31 1964

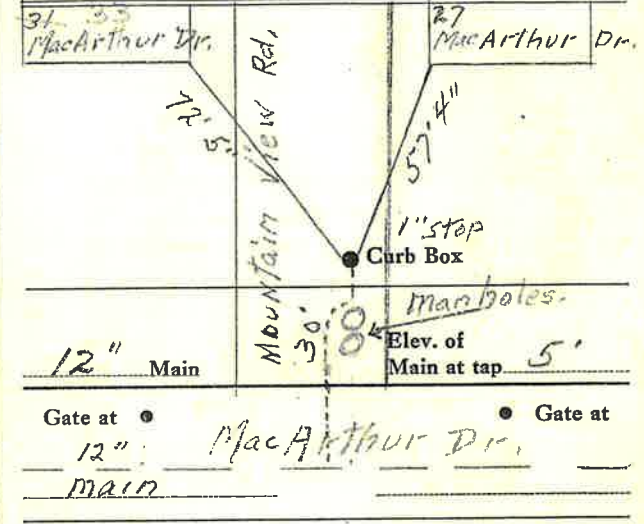

Gate at ● Gate at  
 12" MacArthur Dr.  
 main  
 ● Curb Box  
 North ↑