


LABOR AND MATERIALS

1	Copper	Connection	3/4"	\$
1	Curb	Cock Valve T.S. & V.	3/4 in. OXISEAL	\$
1	Service box	Short 3 1/2 x 4 1/2	4' x 5'	\$
	Old returned	Long 4 1/2 x 5 1/2		
8	3/4 in.	Copper	Pipe at	\$
	Nipples	in. at		\$
	Bushings	to in. at		\$
	Red'g Inc'g	Coupl'gs. to in. at		\$
	Union	in. at		\$
	Meter	in. at		\$
	Lead Joints	at		\$
	Compound Joints	at		\$
	Maintenance Foreman			\$
	Hrs. Water Maint. Man-1	at		\$
	Hrs. Water Maint. Man-2	at		\$
	Hrs. Garage Foreman	at		\$
	Hrs. Labor	at		\$
	Hrs. Compressor	at		\$
	Compensation Ins.	at \$ per C		\$
	Trucking			\$
	Pav't Patch			\$
	Tap By St John & Co			\$
	July-15-1976			\$
	O'head			\$

St. Pt. 5
 Mountain View Rd. Ave. No. 5

Name of Owner
 E. W. COE

Labor and Mat'l. Report July 15 1976

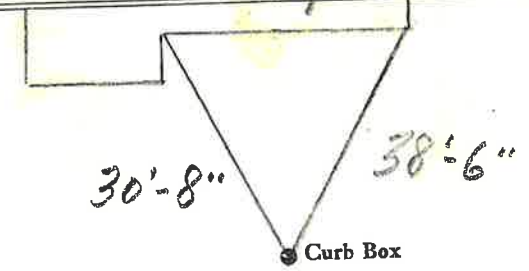

6" Main Elev. of Main at tap 5'

Gate at • Gate at •

• Curb Box

Tax ID# 302.12-12-4