


LABOR AND MATERIALS

1 Copper } Connection $\frac{3}{4}$ " \$ _____
 1 Lead }
 1 Curb } Cock } $\frac{3}{4}$ in. \$ _____
 } Valve }
 } T.S. & V. }
 1 Service box { Short $3\frac{1}{2}$ x $4\frac{1}{2}$ }
 Old returned { Long $4\frac{1}{2}$ x $5\frac{1}{2}$ }
 } Buff. or Rdway } \$ _____
 27 Ft. $\frac{3}{4}$ in. { Copper } Pipe at \$ _____
 } G.I. }
 } G.I. }
 Nipples in. at \$ _____
 Bushings to in. at \$ _____
 1 Red'g }
 Inc'g } Coupl'gs $\frac{3}{4}$ to $\frac{3}{4}$ in. at \$ _____
 } Cop. to Cop.
 Union in. at \$ _____
 Meter in. at \$ _____
 Lead Joints at \$ _____
 Compound Joints at \$ _____
 Maintenance Foreman \$ _____
 Hrs. Water Maint. Man-1 at \$ _____
 Hrs. Water Maint. Man-2 at \$ _____
 Hrs. Garage Foreman at \$ _____
 Hrs. Labor at \$ _____
 Hrs. Compressor at \$ _____
 Compensation Ins. at \$ _____ per C. \$ _____
 Trucking \$ _____
 Pav't Patch \$ _____
 Tap by Gifford \$ _____
 6-25-59 \$ _____
 O'head \$ _____
 \$ _____

✓
 Mountain View St. Rd.
 Ave. No. 8
 Pl.

Name of Owner
 Robt. E. French.

Labor and Mat'l. Report June 25 1959

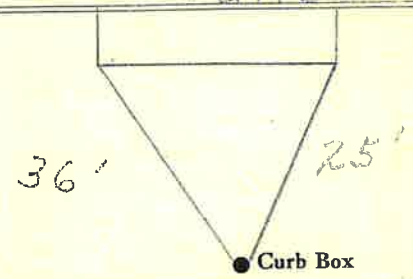

6" Main Elev. of Main at tap 5'
 Gate at • Gate at

• Curb Box