


LABOR AND MATERIALS

1 Copper } Connection ^{3/4"} \$ _____
 Lead }
 1 Curb } Cock } ^{3/4"} in. \$ _____
 } Valve }
 } T.S. & V. }
 1 Service box { Short 3 1/2 x 4 1/2 }
 Old returned { Long 4 1/2 x 5 1/2 } \$ _____
 } Buff or Rdway }
 14 Ft. ^{3/4"} in. { Copper } Pipe at \$ _____
 } G.I. }
 } C.I. }
 _____ Nipples _____ in. at \$ _____
 _____ Bushings _____ to _____ in. at \$ _____
 Red'g }
 Inc'g } Coupl'gs _____ to _____ in. at \$ _____
 _____ Union _____ in. at \$ _____
 _____ Meter _____ in. at \$ _____
 _____ Lead Joints at \$ _____
 _____ Compound Joints at \$ _____
 _____ Maintenance Foreman \$ _____
 _____ Hrs. Water Maint. Man—1 at \$ _____
 _____ Hrs. Water Maint. Man—2 at \$ _____
 _____ Hrs. Garage Foreman _____ at \$ _____
 _____ Hrs. Labor _____ at \$ _____
 _____ Hrs. Compressor at \$ _____
 _____ Compensation Ins. at \$ _____ per C \$ _____
 _____ Trucking \$ _____
 _____ Pav't Patch \$ _____
 Tap by Giffard & Co. \$ _____
 12-17-58. \$ _____
 _____ \$ _____
 _____ \$ _____
 O'head \$ _____
 _____ \$ _____

= 5 app
 79
 Mountain View
 Str. Rd.
 Pl.
 Ave. No. 9

Name of Owner
George Stevenson

Labor and Mat'l. Report Dec. 17 1958

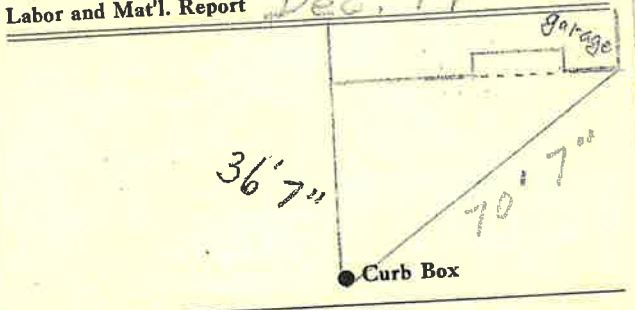

6" Main
 Elev. of Main at tap 6'
 Gate at • Gate at

• Curb Box
 Tax ID # 302.12-9-5