


LABOR AND MATERIALS

1 Copper } Connection  $\frac{3}{4}$ " \$ \_\_\_\_\_  
 Lead }  
 1 Curb } Cock }  $\frac{3}{4}$  in. \$ \_\_\_\_\_  
 Valve }  
 T.S. & V. }  
 1 Service box { Short  $3\frac{1}{2}$  x  $4\frac{1}{2}$  }  
 Old returned { Long  $4\frac{1}{2}$  x  $5\frac{1}{2}$  }  
 Buff or Rdway } \$ \_\_\_\_\_  
 27 Ft.  $\frac{3}{4}$  in. { Copper } Pipe at \$ \_\_\_\_\_  
 { G. I. }  
 { C. I. }  
 Nipples \_\_\_\_\_ in. at \$ \_\_\_\_\_  
 Bushings \_\_\_\_\_ to \_\_\_\_\_ in. at \$ \_\_\_\_\_  
 Red'g }  
 Inc'g } Coupl'gs \_\_\_\_\_ to \_\_\_\_\_ in. at \$ \_\_\_\_\_  
 Union \_\_\_\_\_ in. at \$ \_\_\_\_\_  
 Meter \_\_\_\_\_ in. at \$ \_\_\_\_\_  
 Lead Joints at \$ \_\_\_\_\_  
 Compound Joints at \$ \_\_\_\_\_  
 Maintenance Foreman \$ \_\_\_\_\_  
 Hrs. Water Maint. Man-1 at \$ \_\_\_\_\_  
 Hrs. Water Maint. Man-2 at \$ \_\_\_\_\_  
 Hrs. Garage Foreman \_\_\_\_\_ at \$ \_\_\_\_\_  
 Hrs. Labor \_\_\_\_\_ at \$ \_\_\_\_\_  
 Hrs. Compressor at \$ \_\_\_\_\_  
 Compensation Ins. at \$ \_\_\_\_\_ per C \$ \_\_\_\_\_  
 Trucking \$ \_\_\_\_\_  
 Pav't Patch \$ \_\_\_\_\_  
 Tap by Gissord & Co. 4-16-62 \$ \_\_\_\_\_  
 O'head \$ \_\_\_\_\_

Rd.  
St.  
Pl.

Mountain View Ave. No. 10  
 Name of Owner Corner Halsey Pl.  
 William Resse

Labor and Mat'l. Report April 16 1962-

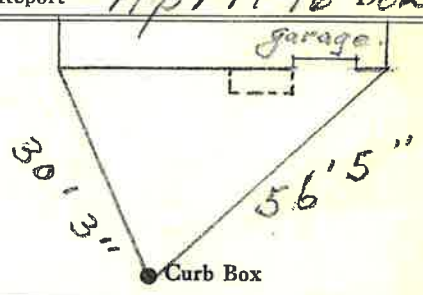

6" C.I.  
Main

Elev. of  
Main at tap 5'

Gate at •

• Gate at

• Curb Box

Tax ID # 302.12-8-1