

LABOR AND MATERIALS


1	Copper Lead	Connection	3/4"	\$	2.71
1	Curb	Cock Valve T.S. & V.	3/4 in.	\$	3.83
1	Service box	} Short 3 1/2 x 4 1/2 Long 4 1/2 x 5 1/2 Buff or Rdway		\$	4.69
	Old returned				
30	Ft. 3/4 in.		Copper G.I. C.I. } Pipe at	45	\$
	Nipples	in. at		\$	
	Bushings	to in. at		\$	
	Red'g Inc'g	Coupl'gs	to in. at	\$	
	Union	in. at		\$	
	Meter	in. at		\$	
	Lead Joints	at		\$	
	Compound Joints	at		\$	
	Maintenance Foreman			\$	
	Hrs. Water Maint. Man-1	at		\$	
12	Hrs. Water Maint. Man-2	at	1.24	\$	14.88
	Hrs. Garage Foreman	at		\$	
28	Hrs. Labor	at	1.13	\$	31.64
	Hrs. Compressor	at		\$	
	Compensation Ins.	at \$ 4.29 per C		\$	2.00
	Trucking			\$	1.50
	Pay't Patch			\$	
	Tap by Gifford			\$	
	4-8-55			\$	
	O'head			\$	
				\$	94.75

St. Pl. Ave. No. 12
 Mountain View Rd.

Name of Owner

Munger

Labor and Mat'l. Report April 8 1955

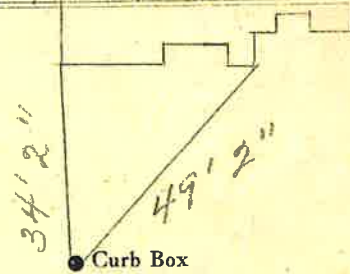

6" Main

Elev. of Main at tap 5 1/2'

Gate at •

• Gate at

• Curb Box

Tax ID# 302.12-8-2