


LABOR AND MATERIALS

1 Copper } 1" X 3/4" Brass T.
 Lead } Connection _____ \$
 1 Curb } Cock } 3/4" Oriseal
 Valve } _____ \$
 T.S. & V. }
 1 Service box } { Short 3 1/2 x 4 1/2 }
 Old returned } { Long 4 1/2 x 5 1/2 }
 Buff or Rdway } _____ \$
 21 Ft. 3/4 in. } { Copper }
 } { G.I. } Pipe at _____ \$
 } { C.I. }
 1 Nipples 3/4 in. at X 3" Brass _____ \$
 Bushings _____ to _____ in. at _____ \$
 1 Red's } 3/4" Iron to Iron stop
 Inc'g } Coupl'gs _____ to _____ in. at _____ \$
 Union _____ in. at _____ \$
 1 Meter 3/4 in. at Male Adapter _____ \$
 Lead Joints at _____ \$
 Compound Joints at _____ \$
 Maintenance Foreman _____ \$
 Hrs. Water Maint. Man-1 at _____ \$
 Hrs. Water Maint. Man-2 at _____ \$
 Hrs. Garage Foreman _____ at _____ \$
 Hrs. Labor _____ at _____ \$
 Hrs. Compressor at _____ \$
 Compensation Ins. at \$ _____ per C _____ \$
 Trucking _____ \$
 Pav't Patch _____ \$
 Tap by Gifford & Co _____ \$
 4-2-64 _____ \$
 O'head _____ \$
 _____ \$

Rd.
 Sr.
 Mountain View Pl.
 Ave. No. 21

Name of Owner Kelly Bros.

Labor and Mat'l. Report Apr. 2 1964

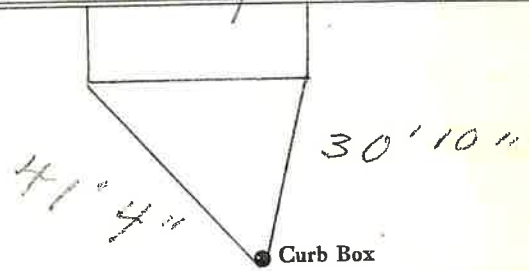

1" Copper Main Elev. of Main at tap 5 1/2

Gate at • Gate at •

• Curb Box

Tax ID # 302.12-5-4