


Labor and Materials

| | | | |
|-------|---|-------|----------|
| 1 | Copper } Connection..... | 3 | \$ 2.60 |
| 1 | Lead } Curb { Cock Valve T. S. & V. }..... | 3 | \$ 2.30 |
| 1 | Service Box { Short 3 1/2 x 4 1/2 }..... | | \$ 1.40 |
| | Old returned { Bulk or Rdway }..... | | |
| 10 | Pt.....in. { Copper Galv. Iron Cast Iron } Pipe at..... | 3 | \$ 2.65 |
| | Nipples.....in. at..... | | \$ |
| | Bushings.....to.....in. at..... | | \$ |
| | Red'g } Couplings.....to.....in. at..... | | \$ |
| | Inc'g } Union.....in. at..... | | \$ |
| | Meter.....in. at..... | | \$ |
| | Lbs. Br. Stone at..... | | \$ |
| | Lbs. Sand at..... | | \$ |
| | Bags Cement at..... | | \$ |
| | Paving Brick { Mack Red Asphalt } at..... | | \$ |
| | Lead Joints at..... | | \$ |
| | Leadite Joints at..... | | \$ |
| 2 | Hrs. Foreman at..... | 1.25 | \$ 4.80 |
| 1.2 | Hrs. Common Labor at..... | | \$ |
| | Hrs. Common Labor at..... | | \$ |
| | Hrs. Mason at..... | | \$ |
| | Hrs. Mason's Helper at..... | | \$ |
| | Hrs. Compressor at..... | | \$ |
| | Compensation Ins..... | 16 | \$ 1.00 |
| | Trucking..... | | \$ 5.00 |
| | Builders' Use of Water..... | Patch | \$ |
| Total | | | \$ 21.24 |

29-11 15
Labor and Material Report *Mar* 29 1929

9 *Maddock Ave*

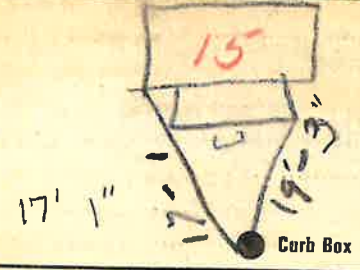

4 Main Elev. of Main at tap 4 1/2
 Gate at ● Gate at ●

● Curb Box

old top shut off
 TAX ID# 302.12-22-8