

LABOR AND MATERIALS

1	Copper	Connection	3/4"	\$ 2.76
1	Lead			
1	Curb	Cock Valve	3/4" in.	\$ 3.49
		T. S. & V.		
1	Service box	Short 3/2 X 4 1/2		
	Old returned	Long 4 1/2 X 5 1/2		
		Buf. or Rdway		\$ 4.74
26	Ft.	3/4" in. Copper	Pipe at 38	\$ 9.88
		G. I.		
		C. I.		
	Nipples	in. at		\$
	Bushings	to in. at		\$
	Red'g			
	Inc'g	Coupl'gs. to in. at		\$
	Union	in. at		\$
	Meter	in. at		\$
	Lead Joints	at		\$
	Compound Joints	at		\$
	Hrs. Water Maint. Man—1	at		\$
10	Hrs. Water Maint. Man—2	at 1.24		\$ 12.40
24	Hrs. Labor—	at 1.13		\$ 27.12
	Hrs. Labor—	at		\$
1	Hrs. Compressor	at		\$ 1.50
	Compensation Ins. at \$4.06	per C		\$ 1.74
	Trucking			\$ 1.00
	Pav't Patch			\$ 9.45
Tap by Gissord 7-21-53				\$
				\$
				\$
	O'head			\$
				\$ 74.08


64.63

63-53

St. _____
 Pl. _____
 Ave. No. 16
 Name of Owner

Russell

Labor and Mat'l. Report July 21 1953

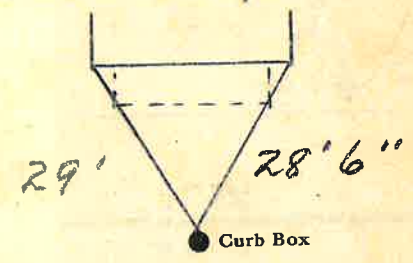

4" Main Elev. of Main at tap 5'
 Gate at ● Gate at ●

● Curb Box

TAX ID # 302.12-21-6