



1936 17A-13
Labor and Material Report Oct 29 1936

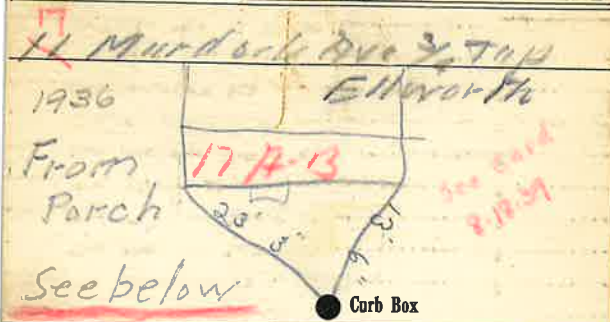

TAX ID# 302.12-22-7

6 Main Elev. of Main at tap 6


Gate at ● Gate at ●

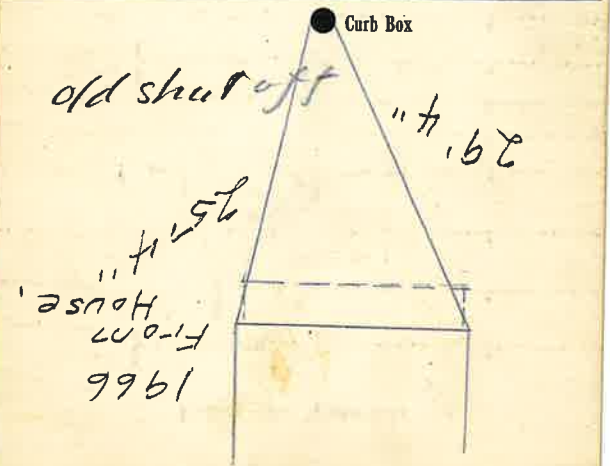

St. 17A-13
Pt. Murdock
Ave. No. 11

Name of Owner

Labor and Mat'l. Report Aug. 10 1939

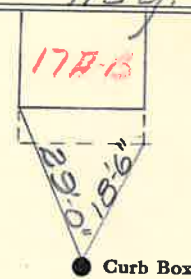

Main Elev. of Main at tap

Gate at ● Gate at ●

● Curb Box

