

LABOR AND MATERIALS

1	Copper	} Connection	\$
	Lead		
1	Curb	} $\frac{3}{4}$ in. oriseal.	\$
	Cock Valve		
	T.S. & V.		
1	Service box	} { Short $3\frac{1}{2}$ x $4\frac{1}{2}$ Long $4\frac{1}{2}$ x $5\frac{1}{2}$ Buff or Rdway }	\$
	Old returned		
24 Ft.	$\frac{3}{4}$ in.	} Pipe at	\$
	Copper		
	G.I.		
	Nipples	in. at	\$
	Bushings	to in. at	\$
	Red'g } Inc'g }	Coupl'gs to in. at	\$
	Union	in. at	\$
	Meter	in. at	\$
	Lead Joints	at	\$
	Compound Joints	at	\$
	Maintenance Foreman		\$
	Hrs. Water Maint. Man-1	at	\$
	Hrs. Water Maint. Man-2	at	\$
	Hrs. Garage Foreman	at	\$
	Hrs. Labor	at	\$
	Hrs. Compressor	at	\$
	Compensation Ins. at \$	per C	\$
	Trucking		\$
	Pav't Patch		\$
	Tap by Seymour & Co.		\$
	8-24-71.		\$
	O'head		\$

Murdock


St.
 Pl.
 Ave. No. 22

Name of Owner

Woodward

Labor and Mat'l. Report

Aug. 24 1971

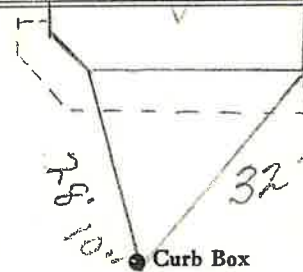

4' Main

Elev. of Main at tap 5'

Gate at ●

● Gate at

● Curb Box

TAX ID# 302.12-21-8