

### Labor and Materials

1	Copper	}	Connection.....	1.23	\$
	Lead				
1	Curb	}	in	1.68	\$
	Cock				
	Valve				
			T. S. & V.		
1	Service Box	}	}	1.75	\$
	Old returned				
			Short 3 1/2 x 4 1/2		
			Long 4 x 5 1/2		
			Buff. or Rdway		
7	Ft. 3/4 in.	}	Pipe at	1.5	\$
			Copper		
			Galv Iron		
			Cast Iron		
	Nipples	in. at			\$
	Bushings	to	in. at		\$
	Red'g	}	Conplings.....	to	in. at
	Inc'g				
	Union	in. at			\$
	Meter	in. at			\$
	Lead Joints	at			\$
	Leadite Joints	at			\$
	Hrs. Foreman	at			\$
15	Hrs. Chauffeur	at	.62 1/2	9.38	\$
6	Hrs. Tapper	at		3.75	\$
18	Hrs. Labor	at	4.5	8.10	\$
	Hrs. Labor	at			\$
	Hrs. Compressor	at			\$
	Compensation Ins.			.65	\$
	Trucking			1.00	\$
	Builders Use of Water				\$
	Tap by Permit				\$
	Water			5.00	\$
					\$
				37.89	\$

42 - 1938


St- 25  
Pt.  
Ave. No. 19

Murdoch

Name of Owner

Gourley

Labor and Mat'l. Report 6-8-38 19

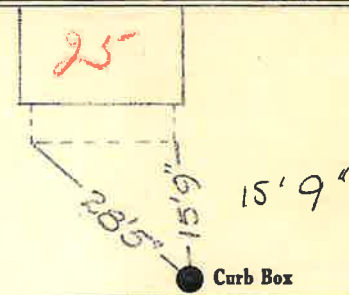

4 Main Elev. of Main at tap 4 1/2

Gate at • Gate at

● Curb Box

Old tap disconnected.

TAX ID# 302.12-22-3

771. No Application