


### Labor and Materials

|                       |   |                 |           |        |    |
|-----------------------|---|-----------------|-----------|--------|----|
| Copper                | } | Connection..... |           |        | \$ |
| Lead                  |   |                 |           |        |    |
| Curb                  | } | Cock            | in        |        | \$ |
|                       |   | Valve           |           |        |    |
|                       |   | T. S. & V.      |           |        |    |
| Service Box           | } | Short 3½ x 4½   |           |        | \$ |
| Old returned          |   | Long 4½ x 5½    |           |        |    |
|                       |   | Buff. or Rdway  |           |        |    |
| Ft. <u>34</u> in.     | } | Copper          | } Pipe at |        | \$ |
|                       |   | Galv Iron       |           |        |    |
|                       |   | Cast Iron       |           |        |    |
| Nipples               |   | in. at          |           |        | \$ |
| Bushings              |   | to              | in. at    |        | \$ |
| Red'g                 | } | Conplings.....  | to        | in. at | \$ |
| Inc'g                 |   |                 |           |        |    |
| Union                 |   | in. at          |           |        | \$ |
| Meter                 |   | in. at          |           |        | \$ |
| Lead Joints           |   | at              |           |        | \$ |
| Leadite Joints        |   | at              |           |        | \$ |
| Hrs. Foreman          |   | at              |           |        | \$ |
| Hrs. Chauffeur        |   | at              |           |        | \$ |
| Hrs. Tapper           |   | at              |           |        | \$ |
| Hrs. Labor            |   | at              |           |        | \$ |
| Hrs. Labor            |   | at              |           |        | \$ |
| Hrs. Compressor       |   | at              |           |        | \$ |
| Compensation Ins.     |   |                 |           |        | \$ |
| Trucking              |   |                 |           |        | \$ |
| Builders Use of Water |   |                 |           |        | \$ |
|                       |   |                 |           |        | \$ |
|                       |   |                 |           |        | \$ |
St. 26  
Pl. 18  
Ave. No. 18

Name of Owner \_\_\_\_\_

Labor and Mat'l. Report 7-6-22 19

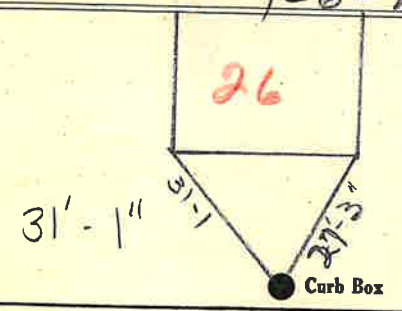

4 Main Elev. of Main at tap.....

Gate at • • Gate at

● Curb Box

TAXID # 302.12-21-9