

LABOR AND MATERIALS


Copper	} Connection	_____	\$ _____	
Lead				
Curb	} Cock Valve T. S. & V. }	_____ in.	\$ _____	
Service box		} Short 3½ x 4½ Long 4½ x 5½ Buff or Rdway }	_____	\$ _____
Old returned				
Ft. _____ in.	} Copper G. I. C. I. }		Pipe at _____	\$ _____
Nipples _____ in.		at _____	\$ _____	
Bushings _____ to _____ in.		at _____	\$ _____	
Red'g } Inc'g }	} Coupl'gs _____ to _____ in.	at _____	\$ _____	
Union _____ in.		at _____	\$ _____	
Meter _____ in.	at _____	\$ _____		
Lead Joints at _____		\$ _____		
Compound Joints at _____		\$ _____		
Maintenance Foreman _____		\$ _____		
Hrs. Water Maint. Man—1 at _____		\$ _____		
Hrs. Water Maint. Man—2 at _____		\$ _____		
Hrs. Garage Foreman _____ at _____		\$ _____		
Hrs. Labor _____ at _____		\$ _____		
Hrs. Compressor at _____		\$ _____		
Compensation Ins. at \$ _____ per C _____		\$ _____		
Trucking _____		\$ _____		
Pav't Patch _____		\$ _____		
_____		\$ _____		
_____		\$ _____		
O'head _____		\$ _____		
_____		\$ _____		

MURDOCK St.
Pl.
Ave. No. 5

Name of Owner _____

Labor and Mat'l. Report _____

19

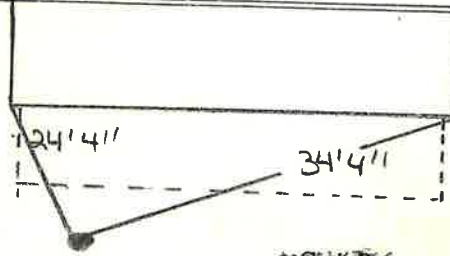

~~● Curb Box~~

4 Main

Elev. of
Main at tap 5'

Gate at ●

● Gate at

*Renewed
Tap*

● Curb Box

TAX ID# 302.12-22-13