


Labor and Materials

Copper } Connection.....	320	
Lead } Connection.....		
Curb } Cock } in.....	1.00	
} Valve } T. S. & V. }		
Service Box } Short 3 1/2 x 4 1/2 }	1.30	
Old returned } Long 4 1/2 x 5 1/2 }		
} Buff or Rdway }		
25 Ft. in. } Copper } Pipe at 1/4 }	5.50	
} Galv. Iron }		
} Cast Iron }		
Nipples..... in. at.....	\$	
Bushings..... to..... in. at.....	\$	
Red'g } Couplings..... to..... in. at.....	\$	
Inc'g }		
Union..... in. at.....	\$	
Meter..... in. at.....	\$	
Lbs. Br. Stone at.....	\$	
Lbs. Sand at.....	\$	
Bags Cement at.....	\$	
Paving Brick } Mack } at.....	\$	
} Red }		
} Asphalt }		
Lead Joints at.....	\$	
Leadite Joints at.....	\$	
3 Hrs. Foreman at..... 6 2 1/2	1.87	
1 Hrs. Common Labor at..... 50	.50	
7 Hrs. Common Labor at..... 40 1/8	2.84	
Hrs. Mason at.....	\$	
Hrs. Mason's Helper at.....	\$	
Hrs. Compressor at.....	\$	
Compensation Ins.....	\$	
1 Trucking.....	1.50	
Builders' Use of Water.....	\$	
Total	16.35	

27-12 28  
 Labor and Material Report Apr 7 1929

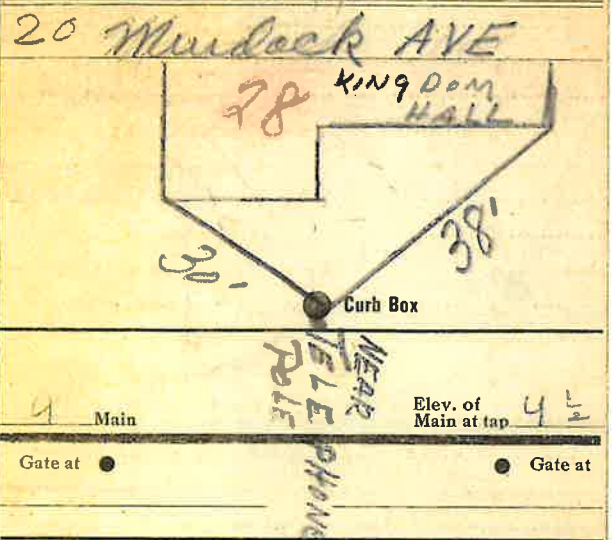

NEAR TELEPHONE

New Tap

28 MURDOCK AVE

TAX ID # 302.12.21-10

KINGDOM HALL