


Labor and Materials

+	Copper } Connection.....	3	\$ 1.50
+	Lead } Cock		
	Waste		
+	Curb { T.S.&V. }in	3	\$ 1.70
		6	
+	Service Box { Short 3 1/2 x 4 1/2 }		\$ 1.50
	Old returned { Long 4 1/2 x 5 1/2 }		
			Buff or Blue
6	Ft. in. { Copper } Pipe at		\$ 1.14
			Cast Iron
	Nipples in. at		\$
	Bushings to in. at		\$
	Red'g } Couplings.....to.....in.at...		\$
	Inc'g }		
	Union..... in. at		\$
	Meter..... in. at		\$
	Lbs. Br. Stone at		\$
	Lbs. Sand at		\$
	Bags Cement at		\$
	Paving Brick { Mack } at		\$
			Red Asphalt
	Lead Joints at		\$
	Leadite Joints at		\$
2	Hrs. Foreman at	6 1/2	\$ 1.88
4	Hrs. Common Labor at	45	\$ 3.60
	Hrs. Common Labor at		\$
	Hrs. Mason at		\$
	Hrs. Masons Helper at		\$
	Hrs. Compressor at		\$
	Compensation Ins		\$ 0.20
	Trucking		\$ 1.50
	Builders Use of Water <i>Part Paid</i>		\$ 5.00
	Total \$ 17.56		

46 34 9
Labor and Material Report July 10 19

3 Murdoch Bk.

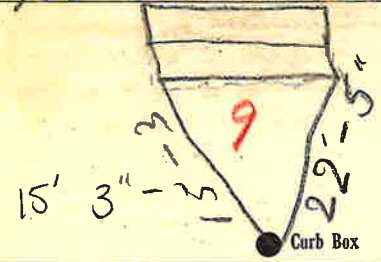

4 Main Elev. of Main at tap 52
Gate at ● Gate at ●

● Curb Box
old tap shut off at main

TAX ID # 302.12-22-11

MM