


**Labor and Materials**

Copper } Connection.....	3	\$ 1.50
Lead } .....		
Curb { Cock Valve } .....	1	\$ 1.70
U.S.&V. } .....		
Service Box { Short 3 1/2 x 4 1/2 } .....		\$ 1.44
Old returned { Long 4 1/2 x 5 1/2 } .....		
8 Ft. 3/4 in. { Copper Galv. Iron } Pipe at .....		\$ 1.52
Cast Iron } .....		
Nipples .....		\$
Bushings .....		\$
Red'g } Couplings.....to.....in.at.....		\$
Inc'g } .....		
Union.....in. at .....		\$
Meter.....in. at .....		\$
Lbs. Br. Stone at .....		\$
Lbs. Sand at .....		\$
Bags Cement at .....		\$
Paving Brick { Mack Red Asphalt } at .....		\$
Lead Joints at .....		\$
Leadite Joints at .....		\$
3 Hrs. Foreman at .....	6.25	\$ 1.88
8 Hrs. Common Labor at .....	4.5	\$ 3.60
Hrs. Common Labor at .....		\$
Hrs. Mason at .....		\$
Hrs. Masons Helper at .....		\$
Hrs. Compressor at .....		\$
Compensation Ins .....		\$ 0.20
Trucking .....		\$ 1.-
Builders Use of Water <i>Paved Patch</i> .....		\$ 5.-
Total		\$ 17.84

36 34 11  
 Labor and Material Report *June 29 1934*

*5 Murdoch Ave*

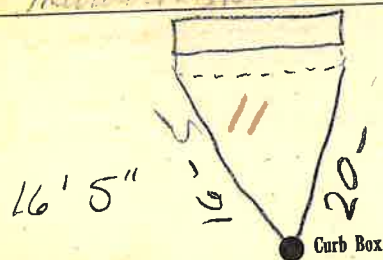

4 Main Elev. of Main at tap 5 1/2  
 Gate at ● ● Gate at

● Curb Box  
*Old trap shut off to main*

TAX ID # 302.12-22-10

*[Signature]*

*[Initials]*