

LABOR AND MATERIALS


1	Copper Lead	Connection	2"	\$
1	Curb	Cock Valve P.S. & V.	2 in.	\$
1	Service box Old returned	Short 3 1/2 x 4 1/2 Long 4 1/2 x 5 1/2 Duff or Rdway.		\$
19	Ft. 2 in.	Copper C.I. C.I.	Pipe at	\$
	Nipples	in. at		\$
	Bushings	to in. at		\$
	Red'g Inc'g	Coupl'gs	to in. at	\$
	Union	in. at		\$
	Meter	in. at		\$
	Lead Joints	at		\$
	Compound Joints	at		\$
	Maintenance Foreman			\$
	Hrs. Water Maint. Man-1	at		\$
	Hrs. Water Maint. Man-2	at		\$
	Hrs. Garage Foreman	at		\$
	Hrs. Labor-	at		\$
	Hrs. Compressor	at		\$
	Compensation Ins. at \$	per C		\$
	Trucking			\$
	Pav't Patch			\$
				\$
				\$
	O'head			\$
				\$

TAP MADE BY
CONTRACTOR
O'head Oct 1972

MURRAY St. 217 Ave. No. 3

Name of Owner
NEW FIRE HOUSE

Labor and Mat'l. Report Oct 7 1972

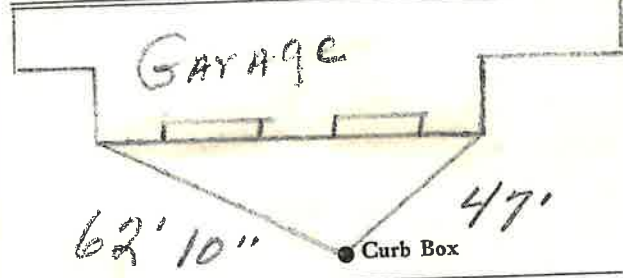

12" Main Elev. of Main at tap 5

Gate at • Gate at

• Curb Box