

LABOR AND MATERIALS

1	Copper	Connection	1"	\$
1	Curb	Cock Valve	1 in. OYISEAL	\$
1	Service box	Short 3 1/2 x 4 1/2		
	Old returned	Long 4 1/2 x 5 1/2		
		Buff or Redway		\$
9	Ft. 1 in.	Copper	Pipe at	\$
		Galv.		
	Nipples	in. at		\$
	Bushings	to in. at		\$
	Red'g			
	Inc'g	Coupl'gs. to in. at		\$
	Union	in. at		\$
	Meter	in. at		\$
	Lead Joints at			\$
	Compound Joints at			\$
	Maintenance Foreman			\$
	Hrs. Water Maint. Man-1 at			\$
	Hrs. Water Maint. Man-2 at			\$
	Hrs. Garage Foreman at			\$
	Hrs. Labor at			\$
	Hrs. Compressor at			\$
	Compensation Ins. at \$	per C		\$
	Trucking			\$
	Pav't Patch			\$
	Tap By Beecher & Co			\$
	MAY-17-1976			\$
	O'head			\$

MURRAY


St. Ave. No. 7-9

Name of Owner

Dr. Vitale Paganelli

Labor and Mat'l. Report

MAY 15 1976

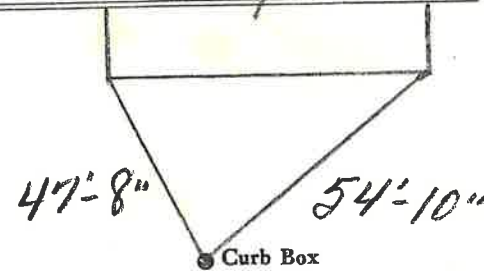

4" Main

Elev. of Main at tap 5'

Gate at •

• Gate at

4-19-13 TAP ON SPRING ST. Curb Box

#7 - TAX ID# 309.12-2-5