

LABOR AND MATERIALS

Copper } Connection _____	\$ _____
Lead } _____	
Curb } Cock _____	in. \$ _____
} Valve _____	
} T.S. & V. _____	
Service box { Short 3½ x 4½ }	
Old returned { Long 4½ x 5½ }	\$ _____
Ft. 2 in. { Copper } Pipe at _____	\$ _____
} G.I. _____	
} G.I. _____	
Nipples _____ in. at _____	\$ _____
Bushings _____ to _____ in. at _____	\$ _____
Red'g } _____	
Inc'g } Coupl'gs _____ to _____ in. at _____	\$ _____
Union _____ in. at _____	\$ _____
Meter _____ in. at _____	\$ _____
_____	\$ _____
Compound Joints at _____	\$ _____
Maintenance Foreman _____	\$ _____
Hrs. Water Maint. Man-1 at _____	\$ _____
Hrs. Water Maint. Man-2 at _____	\$ _____
Hrs. Garage Foreman _____ at _____	\$ _____
Hrs. Labor _____ at _____	\$ _____
Hrs. Compressor at _____	\$ _____
_____	\$ _____
Trucking _____	\$ _____
Pav't Patch _____	\$ _____
_____	\$ _____
_____	\$ _____
_____	\$ _____
_____	\$ _____


MURRAY

St. ~~Pl.~~
Ave. No. 11

Name of Owner

Labor and Mat'l. Report

1988

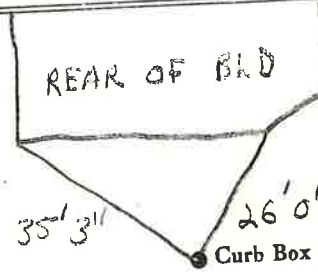

_____	Main	Elev. of Main at tap _____
Gate at ●		● Gate at

● Curb Box

TAP ON MURRAY
TAX ID # 309.12.2-4