

LABOR AND MATERIALS

1	Copper	Connection	3/4"		\$ 2.76
	Lead				
1	Curb	Cock Valve	3/4 in.		\$ 3.49
		T. S. & V.			
1	Service box	Short 3/4 X 4 1/2			
	Old returned	Long 4 1/2 X 5 1/2			\$ 4.75
		Buff or Rdway			
7	Ft.	3/4 in. Copper			
		G. I.	Pipe at	35	\$ 8.05
		C. I.			
	Nipples	in. at			\$
	Bushings	to in. at			\$
	Red'g				
	Inc'g	Coupl'gs to in. at			\$
	Union	in. at			\$
	Meter	in. at			\$
	Lead Joints	at			\$
	Compound Joints	at			\$
	Hrs. Water Maint. Man-1	at			\$
10	Hrs. Water Maint. Man-2	at	1.24		\$ 12.40
2.5	Hrs. Labor	at			\$ 28.25
	Hrs. Labor	at			\$
1	Hrs. Compressor	at			\$ 1.50
	Compensation Ins.	at \$ 3.706 per C.			\$ 1.51
	Trucking				\$ 1.00
	Pav't Patch				\$ 13.50
	Tap made by Gifford				\$
	Aug 19-52				\$
	O'head				\$


TAP CHANGED OVER \$ 77.21
 FROM OLD 8" MAIN TO NEW
 MAIN BY BEECHER & CO
 Dec. 3-1973

St.
 Pl. 49
 Ave. No.

Murray

Mahar

Labor and Mat'l. Report Aug 19 1952

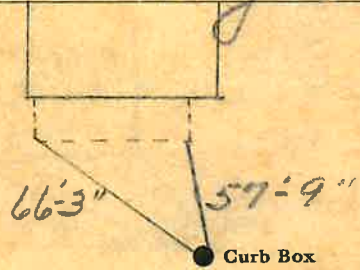

12"
~~8"~~ Main

Elev. of Main at tap 5 1/2

Gate at ● ● Gate at

7' to main

3/4" Copper ● Curb Box

TAX ID# 309.12-11-4