

LABOR AND MATERIALS


1 Copper } Connection 3/4" \$  
 lead }  
 1 Curb } Cock } 3/4" (MARKET)  
 Valve } (ORISEAL)  
 T.S. & V. }  
 1 Service box { Short 3 1/2 x 4 1/2 }  
 Old returned { Long 4 1/2 x 5 1/2 }  
 { Buff or Rdway } \$  
 33 Ft. 3/4 in. { Copper } Pipe at \$  
 { C.I. }  
 { C.I. }  
 Nipples in. at \$  
 Bushings to in. at \$  
 Red'g }  
 Inc'g } Coupl'gs to in. at \$  
 Union in. at \$  
 Meter in. at \$  
 Lead Joints at \$  
 Compound Joints at \$  
 Maintenance Foreman \$  
 Hrs. Water Maint. Man-1 at \$  
 Hrs. Water Maint. Man-2 at \$  
 Hrs. Garage Foreman at \$  
 Hrs. Labor at \$  
 Hrs. Compressor at \$  
 Compensation Ins. at \$ per C \$  
 Trucking \$  
 Pav't Patch \$  
 \$  
 Tap made By St John  
 & Co \$  
 O'head Nov 6 - 1973 \$  
 \$

Changed over from old 8" MAIN  
 To New 12" MAIN  
 11-6-1973

MURRAY ST. Ave. No. 54

Name of Owner  
 VERNARD A. Speedy

Labor and Mat'l. Report Nov. 6 1973

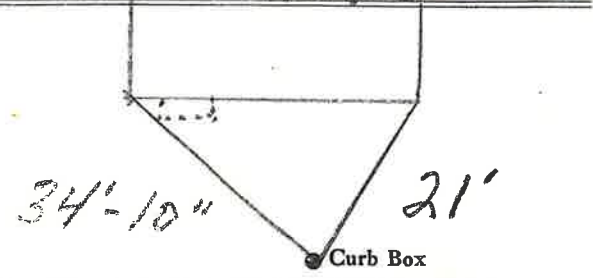

12" Main Elev. of Main at tap 5 1/2'  
 Gate at • Gate at

• Curb Box

Tax ID # 309.12-5-116