


Labor and Materials

1	Copper	Connection		\$ 2.70
	Lead			
1	Curb	Cock Valve T.S. & V.	in.	\$ 2.39
1	Service Box	Short 3/4x4 1/2		\$ 1.45
	Old returned	Long 4 1/2x5 1/2		
		Butt or Rdway		
25	Ft.	Copper	Pipe at	\$ 6.21
23	in.	Galv. Iron		
		Cast Iron		
	Nipples	in. at		\$
	Bushings	" to in. at		\$
1	Red's Inc's	3/4 Cop. Couplings	to Cop. in. at	\$
	Union	in. at		\$
	Meter	in. at		\$
	Lbs. Br. Stone	at		\$
	Lbs. Sand	at		\$
	Bags Cement	at		\$
	Paving Brick	Mack Red Asphalt	at	\$
	Lead Joints	at		\$
	Leadite Joints	at		\$
3	Hrs. Foreman	at		\$ 1.88
14	Hrs. Common Labor	at		\$ 6.30
	Hrs. Common Labor	at		\$
	Hrs. Mason	at		\$
	Hrs. Mason's Helper	at		\$
	Hrs. Compressor	at		\$
	Compensation Ins			\$.25
	Trucking			\$ 1.-
	Builders' Use of Water			\$ 5.-
Total \$				27.18

30-54 18
 Labor and Material Report 1930

12 Nelson St.

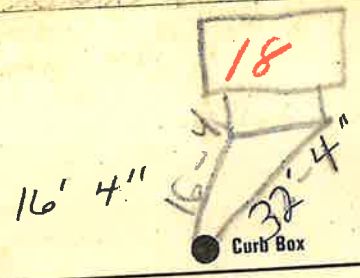

6" Main
 Elev of Main at tap 5 1/2
 Gate at ● Gate at ●

● Curb Box

Old tap dis-
 connected.

TAX ID # 302.20-10-5