


LABOR AND MATERIALS

1	Copper Lead	Connection	3/4"	\$	2.71
1	Curb	Cock Valve T.S. & V.	3/4 in.	\$	3.83
Same	Service box	Short 3 1/2 x 4 1/2		\$	4.69
	Old returned	Long 4 1/2 x 5 1/2		\$	
27		Buff or Rdway		\$	
25	Ft.	Copper Pipe	3/4 in.	\$	11.25
		G.I.		\$	50
		G.I.		\$	
	Nipples	in. at		\$	
	Bushings	to in. at		\$	
	Red'g Inc'g	Coupl'gs to in. at		\$	
1	Union	3/4 in. at	Cop. to Cop. Coupling	\$	
	Meter	in. at		\$	
	Lead Joints	at		\$	
	Compound Joints	at		\$	
	Maintenance Foreman			\$	
	Hrs. Water Maint. Man-1	at		\$	
9 1/2	Hrs. Water Maint. Man-2	at	1.24	\$	11.78
	Hrs. Garage Foreman	at		\$	
18	Hrs. Labor	at	1.13	\$	20.34
	Hrs. Compressor	at		\$	
	Compensation Ins.	at \$	4.29 per C	\$	1.38
	Trucking			\$	1.50
	Pav't Patch			\$	14.40
	Tap by Gifford		8-22-55	\$	
				\$	
				\$	
	O'head			\$	
				\$	71.88

St. _____
 Ave. No. 8

Nelson
 Name of Owner
 Tarrentelli

Labor and Mat'l. Report Aug. 22 19 55

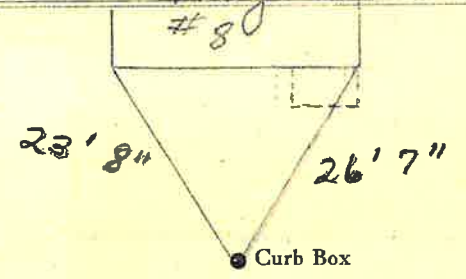

6
 Main
 Elev. of Main at tap 5'

Gate at ● Gate at ●
 ● Curb Box
 Tax ID# 302.20-10-1