

LABOR AND MATERIALS

1	Copper	{ Connection	3/4		\$ 2.29
	Lead				
1	Curb	{ Cock Valve	3/4 in.		\$ 2.70
		{ T.S. & V.			
1	Service box	Short	3 1/2 x 4 1/2		\$ 4.25
	Old returned	Long	4 1/2 x 5 1/2		
		Buff or Rdway			
9	Ft. 3/4 in.	{ Copper		35	\$ 3.15
		{ G.I.			
		{ C.I.			
	Nipples	in. at			\$
	Bushings	to in. at			\$
	Red'g	{ Coupl'gs	to in. at		\$
	Inc'g				
	Union	in. at			\$
	Meter	in. at			\$
	Lead Joints	at			\$
	Compound Joints	at			\$
	Hrs. Water Maint. Man	1 at			\$
4	Hrs. Water Maint. Man	2 at	102		\$ 408
14	Hrs. Labor	at	91		\$ 1274
	Hrs. Labor	at			\$
1	Hrs. Compressor	at	120		\$ 120
	Compensation Ins. at \$	per C.			\$ 37
	Trucking				\$ 1-
	Pav't Patch				\$ 12.83
	<i>Tap 4 Meters</i>				\$
					\$
					\$
	O'head				\$
					\$ 44.61

60-1950


Nelson

St. Pl. Ave. No. 9

Name of Owner

Bocais

Labor and Mat'l. Report June 15 1950

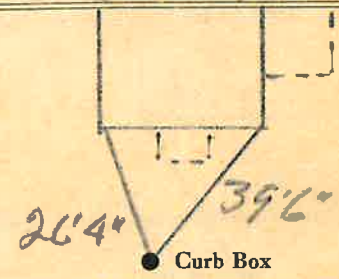

6" Main

Elev. of Main at tap 5

Gate at ●

● Gate at

● Curb Box

Tax ID # 302.20-11-20