

LABOR AND MATERIALS

1	Copper Lead	} Connection	3/4		\$ 1.35
1	Curb	} Cock Valve	3/4	in.	\$ 1.80
		} T. S. & V.			
1	Service Box	} Short 3/4x4 1/2 Long 4 1/2x5 1/2 Buffer Rdway.			\$ 1.70
	Old returned				
26	24 Ft.	} Copper Galv. Iron Cast Iron	3/4	in.	\$ 4.37
	Nipples			in. at	\$
	Bushings			to in. at	\$
1	Red'g Inc'g	} Couplings	3/4	to Cop in. at	\$?
	Union			in. at	\$
	Meter			in. at	\$
	Lead Joints at				\$
	Leadite Joints at				\$
	Hrs. Foreman at				\$
3	Hrs. Chauffeur at		6 1/2		\$ 1.87
6	Hrs. Tapper at		7		\$ 3.75
	Hrs. Labor at				\$
17	Hrs. Labor at		45		\$ 5.40
	Hrs. Compressor at				\$
	Compensation Ins.				\$.34
	Trucking				\$ 1.00
	Builders Use of Water		Patch		\$ 5.00
	Taps by Hassel				\$
					\$
					\$
					\$ 26.53

1 4 5 1941

St.
Pl.

16

Nelson

Ave. No.


10

Name of Owner

Leidel

Labor and Mat'l. Report

Nov 26 1941

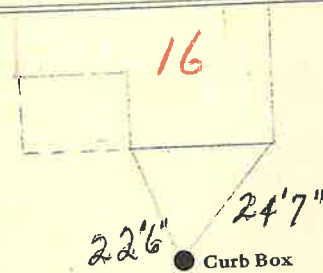

6"
Main

Elev. of
Main at tap 6

Gate at ●

● Gate at

● Curb Box

Tax ID # 302.20-10-4

11